


COPYRIGHT  
THIS DRAWING IS A COPYRIGHT. IT IS NOT TO BE REPRODUCED, COPIED  
HAND OVER TO A THIRD PARTY OR USED FOR ANY OTHER PURPOSE  
OTHER THAN FOR THE PROJECT INVOLVED, WITHOUT THE KNOWLEDGE  
OF THE ARCHITECT.

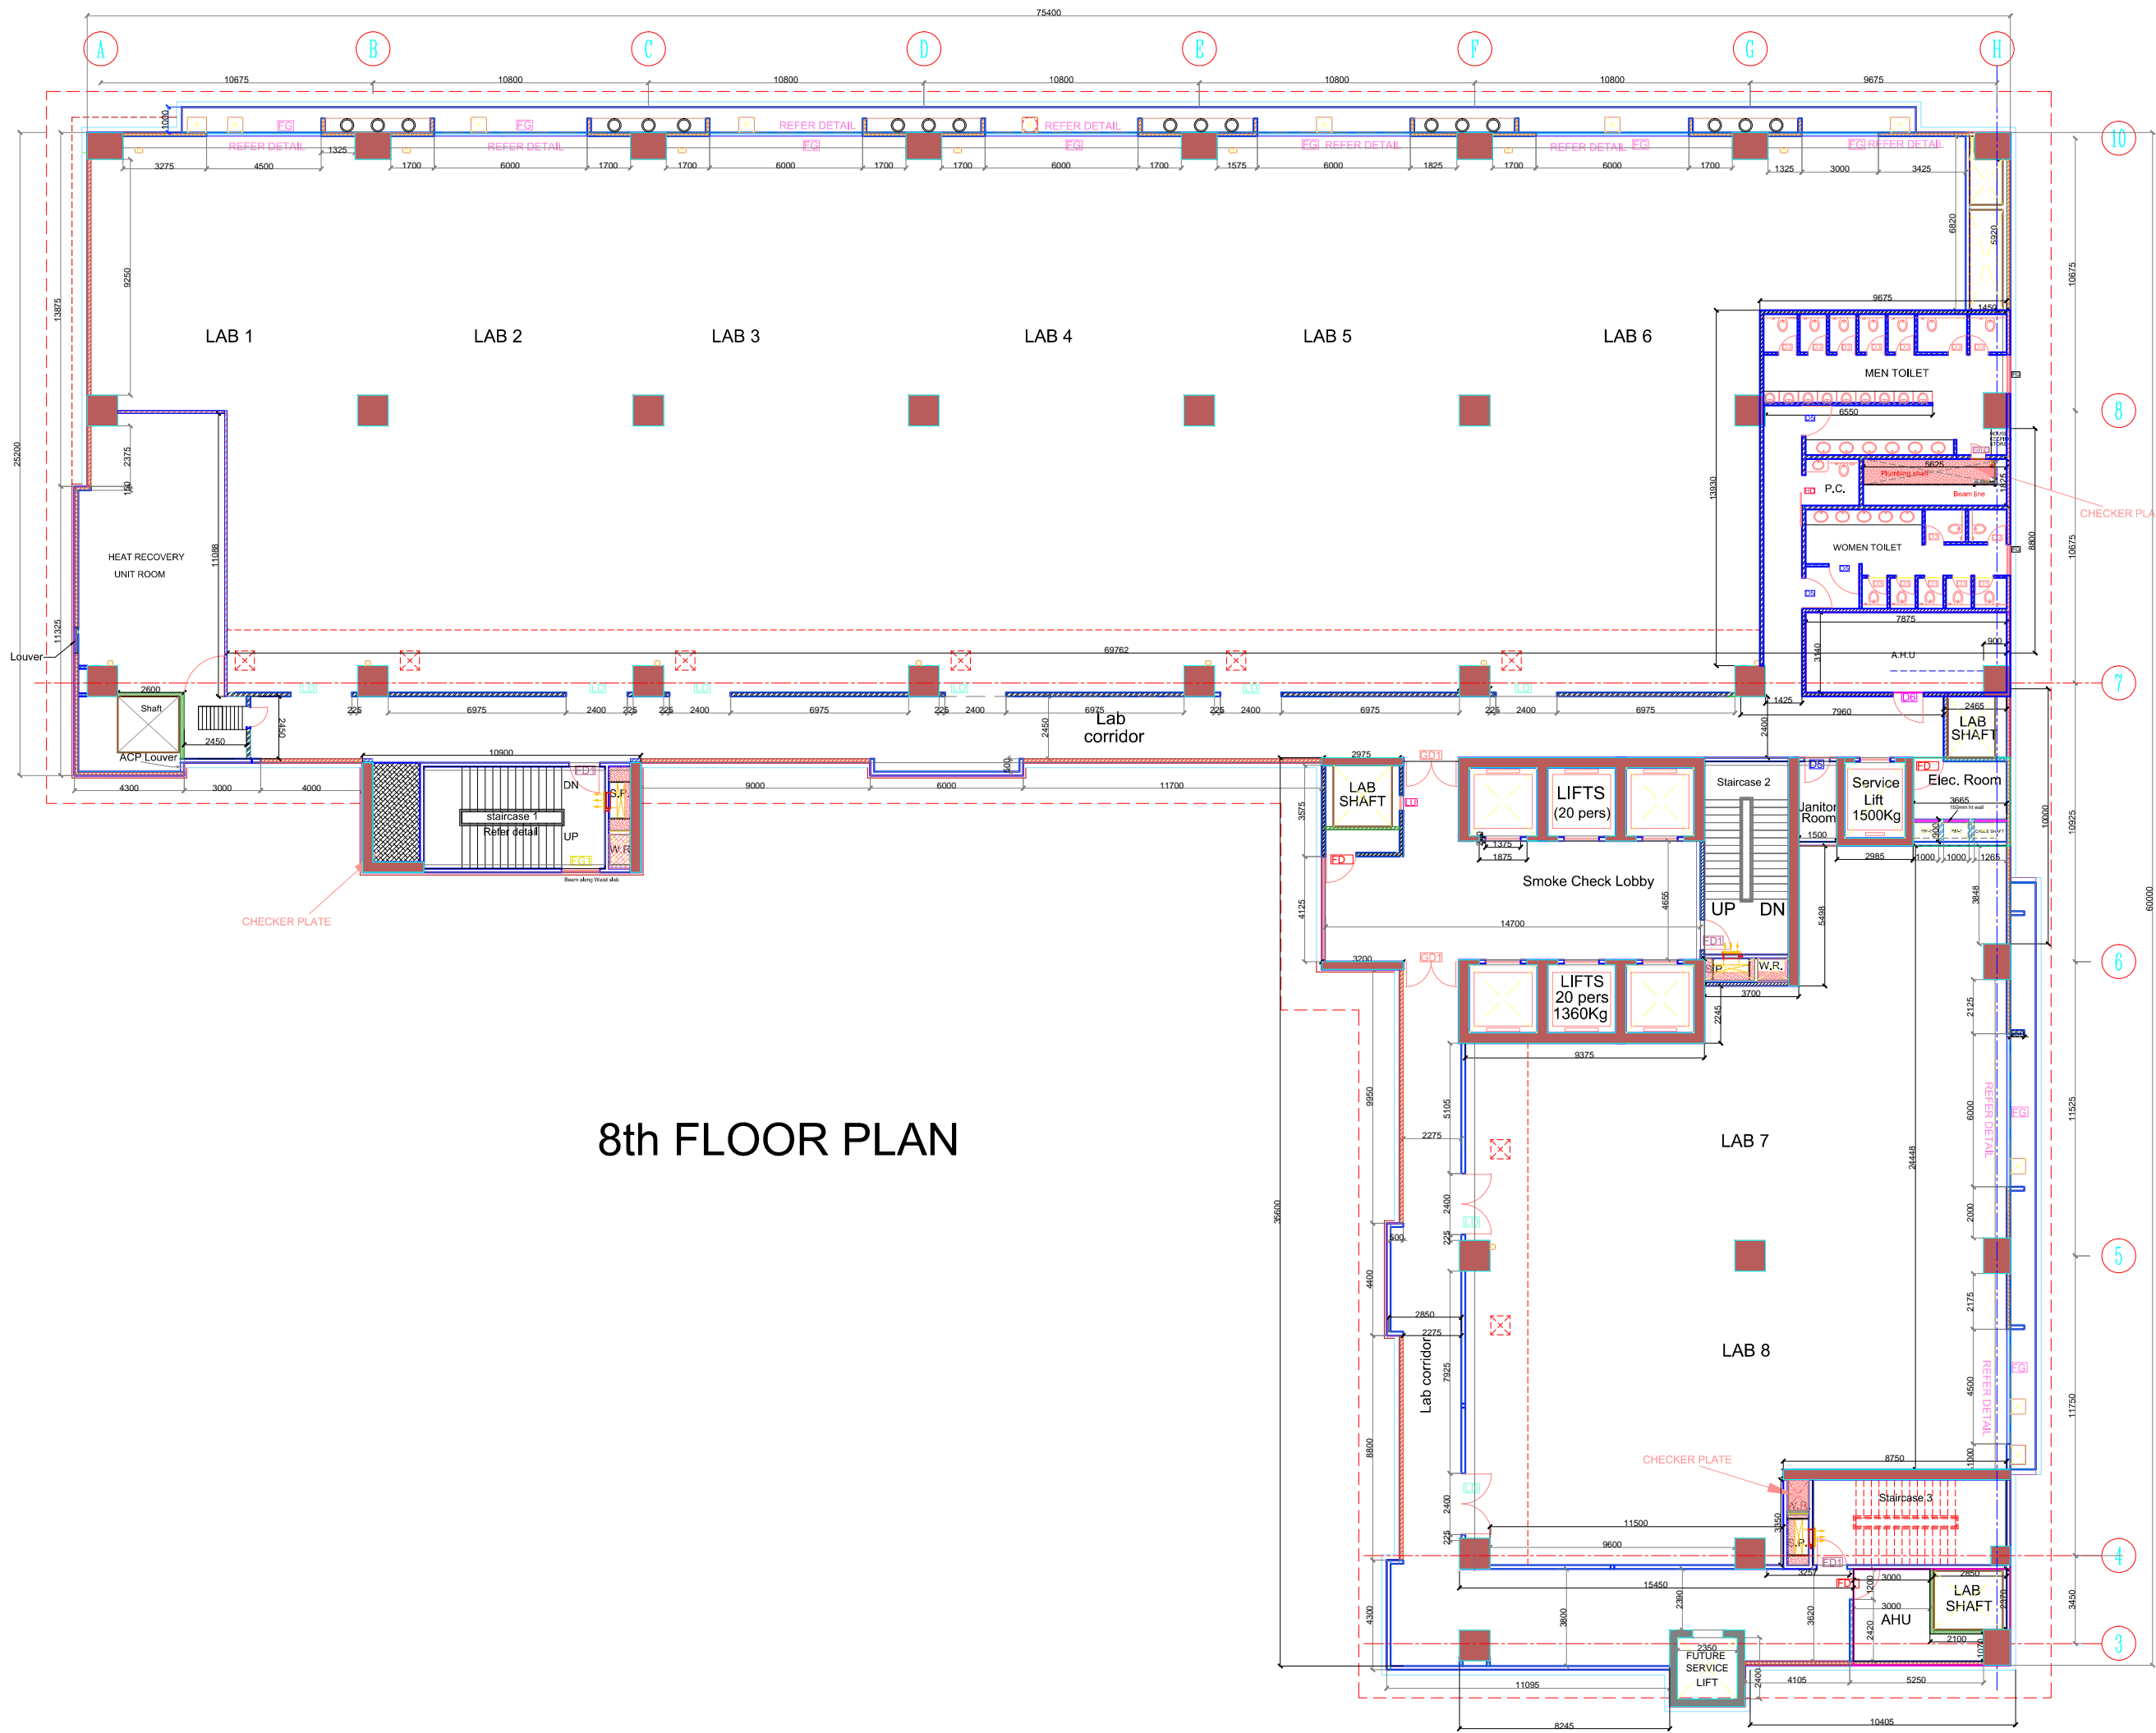

# 8th FLOOR PLAN

SCHEDULE OF JOINERY		
TYPE	DESCRIPTION	SIZE
GD1	GLASS DOOR	2.0m x 2.4m
GD2	GLASS DOOR ( Food Court)	1.2m x 2.1m
FD1	FIRE RATED DOOR (emer staircase)	1.2m x 2.1m
FD2	FIRE RATED DOOR LEAF AND HALF (fan room)	1.5m x 2.1m
FD3	FIRE RATED DOOR	1.2m x 2.1m
FD4	FIRE RATED DOOR( service floor)	0.9m x 1.7m
HD	SLIDING DOOR WITH HANDICAP FACILITY	1.2m x 2.1m
D1	FLUSH DOOR	1.0m x 2.1m
D2	DOUBLE FLUSH DOOR Convention	2.0m x 2.1m
D3	FLUSH DOOR (Toilet WC)	0.75m x 2.1m
D4	DOUBLE FLUSH DOOR	2.0m x 2.1m
D5	FLUSH DOOR(Toilet entry)	1.2m x 2.1m
D6	FLUSH DOOR	1.2m x 2.1m
D7	FLUSH DOOR	1.0m x 2.1m
LD	LAB METAL DOUBLE DOOR	2.4m x 2.4m
FSD	FIRE RATED TOILET SHAFT DOOR	0.6m x 2.1m
FCD	FIRE RATED COMMUNICATION SHAFT DOOR	0.6m x 1.7m

ENGINEERING CONSULTANT  
**Taamaesek Engineering Consortium**  
New no. 5, Old no.2a, Bishop Wallers Avenue west, Mylapore,  
Chennai - 600 004. Ph : 044-24671157/1139. Fax : 044-24672237.  
url:www.taamaesek.com  
e-mail: info@taamaesek.com

OWNER  
TICEL Bio Park Ltd,  
Taramani Road, Taramani  
Chennai - 600 113, INDIA.  
Phone : 91-44-2254 2061 / 2062  
Fax : 91-44-2254 2055  
E-mail : md@ticelbiopark.com

PROJECT:  
TICEL BIO PARK - II  
AT TARAMANI, CHENNAI-113

DRAWING STAGE:  
AS BUILT DRAWING

Name	
Drawn by:	Ganesh
Checked by:	Dinesh
Approved by:	Rajeswari

DATE  
Scale: NTS  
DRAWING TITLE:  
**8th FLOOR PLAN**

Drawing number: TICEL/TMA/ARCH/007

PROJECT	ARCHITECTS	LEVEL	TYPE OF DRAWING	DWG NO.	REV
TICEL	TMA	-	CMDA	007	R1

