


COPYRIGHT
 THIS DRAWING IS A COPYRIGHT. IT IS NOT TO BE REPRODUCED, COPIED, HANDLED OVER TO A THIRD PARTY OR USED FOR ANY OTHER PURPOSE OTHER THAN FOR THE PROJECT INVOLVED, WITHOUT THE KNOWLEDGE OF THE ARCHITECT.

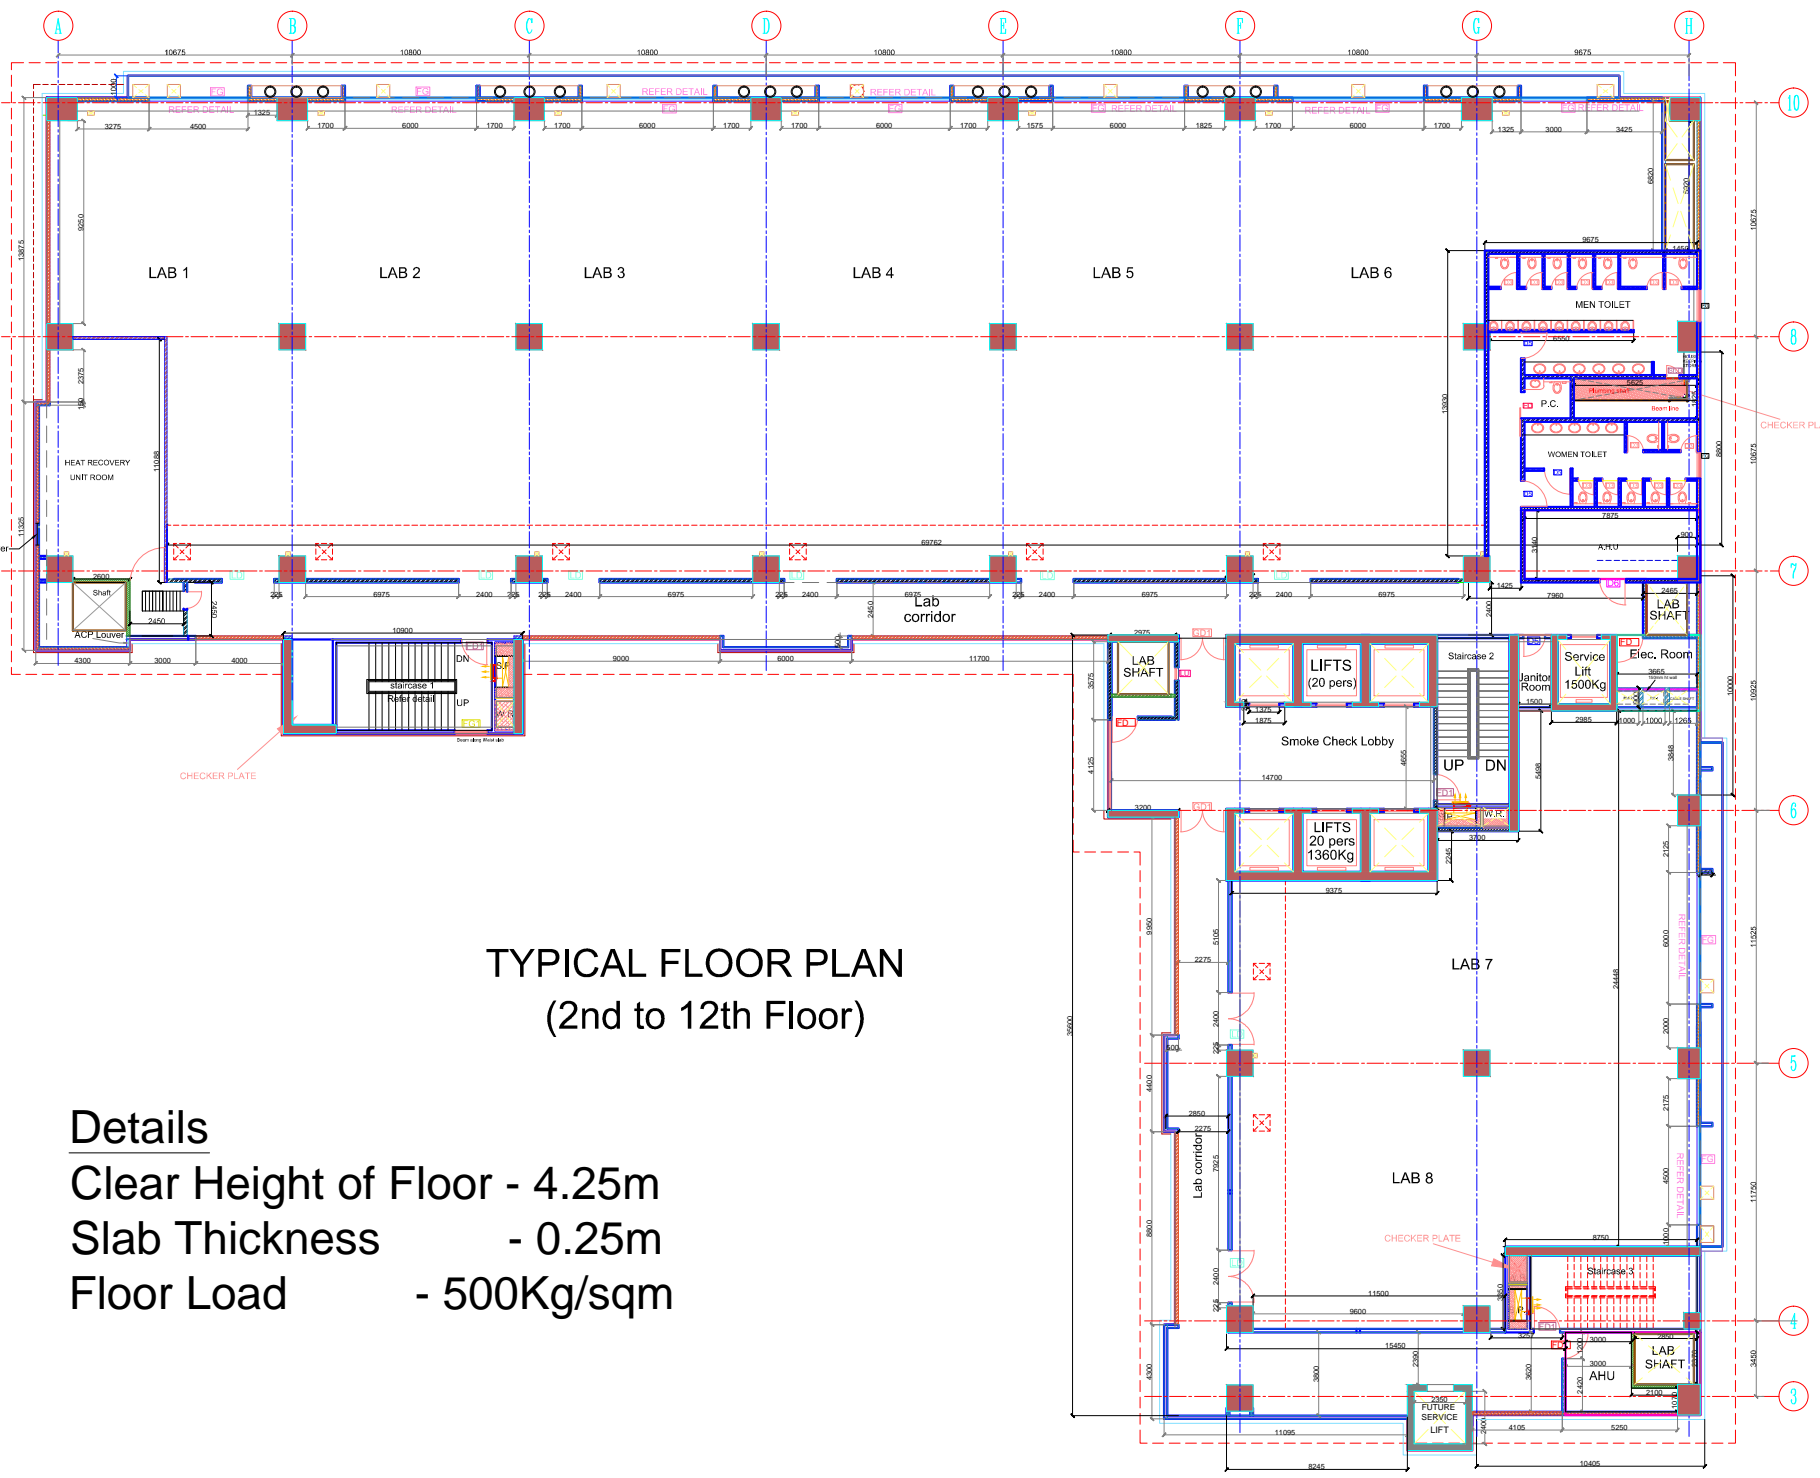

TYPICAL FLOOR PLAN
 (2nd to 12th Floor)

Details
 Clear Height of Floor - 4.25m
 Slab Thickness - 0.25m
 Floor Load - 500Kg/sqm

SCHEDULE OF JOINERY		
TYPE	DESCRIPTION	SIZE
GD1	GLASS DOOR	2.0m x 2.4m
GD2	GLASS DOOR (Food Court)	1.2m x 2.1m
FD1	FIRE RATED DOOR (emer staircase)	1.2m x 2.1m
FD2	FIRE RATED DOOR LEAF AND HALF (fan room)	1.5m x 2.1m
FD3	FIRE RATED DOOR	1.2m x 2.1m
FD4	FIRE RATED DOOR (service floor)	0.9m x 1.7m
HD	SLIDING DOOR WITH HANDICAP FACILITY	1.2m x 2.1m
D1	FLUSH DOOR	1.0m x 2.1m
D2	DOUBLE FLUSH DOOR Convention	2.0m x 2.1m
D3	FLUSH DOOR (Toilet WC)	0.75m x 2.1m
D4	DOUBLE FLUSH DOOR	2.0m x 2.1m
D5	FLUSH DOOR (Toilet entry)	1.2m x 2.1m
D6	FLUSH DOOR	1.2m x 2.1m
D7	FLUSH DOOR	1.0m x 2.1m
LD	LAB METAL DOUBLE DOOR	2.4m x 2.4m
FSD	FIRE RATED TOILET SHAFT DOOR	0.8m x 2.1m
FCD	FIRE RATED COMMUNICATION SHAFT DOOR	0.8m x 1.7m

ENGINEERING CONSULTANT
Taamaasek Engineering Consortium
 New no. 5, OH no.2a, Bishop Wallers Avenue west, Mylapore,
 Chennai - 600 004, Ph: 044-24671157/1139, Fax: 044-24672237,
 ur:www.taamaasek.com
 e-mail: info@taamaasek.com

OWNER
TICEL Bio Park Ltd.
 Taramani Road, Taramani
 Chennai - 600 113, INDIA.
 Phone : 91-44-2254 2061 / 2062
 Fax : 91-44-2254 2055
 E-mail : mo@ticelbiopark.com

PROJECT:
 TICEL BIO PARK - II
 AT TARAMANI, CHENNAI-113

DRAWING STAGE:
 AS BUILT DRAWING

Name	
Drawn by:	Ganesh
Checked by:	Dinesh
Approved by:	Rajeeswari
DATE	

DRAWING TITLE:
 TYPICAL FLOOR PLAN
 (2nd to 12th Floor)

PROJECT	ARCHITECTS	LEVEL	TYPE OF DRAWING	DWG NO.	REV
TICEL	TMA	-	CMDA	007	R1

